

STATE ENGINEER  
Salem, Oregon

YAMH  
6422

# Well Record


STATE WELL NO. 5/3W-8H  
COUNTY Yamhill  
APPLICATION NO. GR-3284

OWNER: W. Leo Schrammeck MAILING ADDRESS: Dayton

LOCATION OF WELL: Owner's No. CITY AND STATE: Oregon

SE 1/4 NE 1/4 Sec. 8 T. 5 S., R. 3 W., W.M.

Bearing and distance from section or subdivision corner 550' N. & 200' E. from center Sec. 8

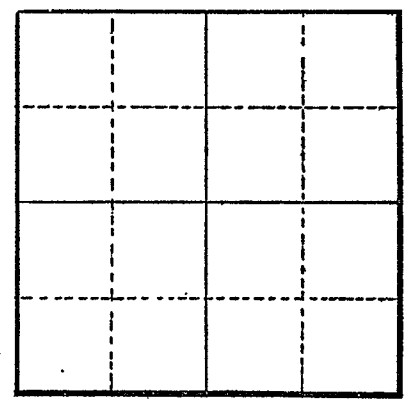

Section

Altitude at well

TYPE OF WELL: drilled Date Constructed 1941

Depth drilled 37 1/2 Depth cased 37 1/2

### CASING RECORD:

12 inch

### FINISH:

### AQUIFERS:

sand and gravel

### WATER LEVEL:

24'

PUMPING EQUIPMENT: Type Fairbanks Morse H.P. 1/2  
Capacity 20 G.P.M.

### WELL TESTS:

Drawdown ft. after hours G.P.M.  
Drawdown ft. after hours G.P.M.

USE OF WATER Irrigation Temp. °F. 19

SOURCE OF INFORMATION GR-3053

DRILLER or DIGGER

### ADDITIONAL DATA:

Log Water Level Measurements Chemical Analysis Aquifer Test

### REMARKS: