

STATE ENGINEER
Salem, Oregon

YAMHILL
6424

Well Record

STATE WELL NO. 5/3w-8 J
COUNTY YAMHILL
APPLICATION NO. GR 2260
G.R. Cert. 2157

OWNER: Maurice Henry Goodrich


MAILING ADDRESS: Rt 1

LOCATION OF WELL: Owner's No.

CITY AND STATE: Dayton, Oregon

NE 1/4 SE 1/4 Sec. 8 T. 5 N. S., R. 3 E. W., W.M.

Bearing and distance from section or subdivision corner 2350' N & 600' W from the SE corner of section 8

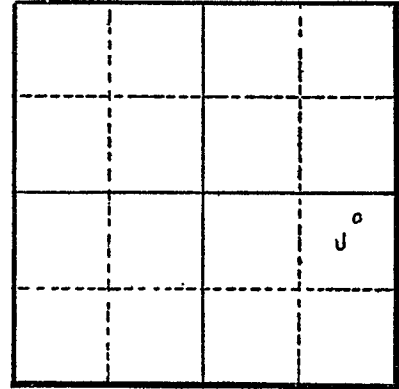

Section 8

Altitude at well

TYPE OF WELL: Drilled Date Constructed 1950

Depth drilled 96 Depth cased

CASING RECORD:

8-inch

FINISH:

Casing perforated from 54 to 96 feet.

AQUIFERS:

WATER LEVEL:

36 feet below land surface

PUMPING EQUIPMENT: Type Jacuzzi Turbine H.P. 7 1/2
Capacity 312 G.P.M.

WELL TESTS:

Drawdown 60 ft. after Pumping 205 hours G.P.M.
Drawdown ft. after hours G.P.M.

USE OF WATER Irrigation 40 ac Temp. °F., 19

SOURCE OF INFORMATION GR 2260

DRILLER or DIGGER Carl Saunders

ADDITIONAL DATA:

Log No. Water Level Measurements Chemical Analysis Aquifer Test

REMARKS:

7-30-69 This well replaced by new well 50 ft to East. Well comp. on July 10, 1969 100' deep by Rolf. Shelburne