

STATE ENGINEER
Salem, Oregon

YAMHILL Well Record
6451

STATE WELL NO. 5/3W - 9A
COUNTY YAMHILL
APPLICATION NO. GR-2032

OWNER: U. S. Alderman


MAILING ADDRESS:

LOCATION OF WELL: Owner's No. #4

CITY AND STATE: Dayton, Oregon

NE 1/4 NE 1/4 Sec. 9 T. 5 N. S., R. 3 E. W., W.M.

Bearing and distance from section or subdivision corner 1650' S. 39° 58' W.

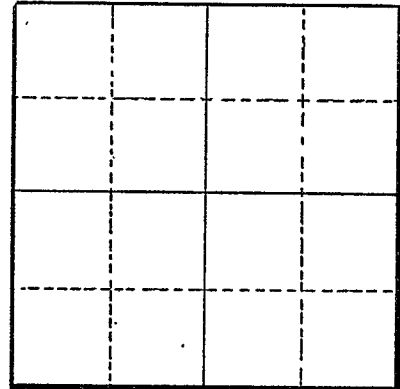

Section

Altitude at well

TYPE OF WELL: Drilled Date Constructed 1946

Depth drilled 138 Depth cased 138

CASING RECORD:

10-inch

FINISH:

Perforations from 128 to 136

AQUIFERS:

Sand and shale

WATER LEVEL:

77-feet

PUMPING EQUIPMENT: Type Fairbanks Morse 7" Turbine
Capacity 236 G.P.M.

H.P. 20

WELL TESTS:

Drawdown ft. after hours G.P.M.

Drawdown ft. after hours G.P.M.

USE OF WATER Industrial Temp. °F., 19

SOURCE OF INFORMATION GR-1958

DRILLER or DIGGER Fred Wymore, Willamette Drilling Co., Rt. 2, Salem, Oregon

ADDITIONAL DATA:

Log Water Level Measurements Chemical Analysis Aquifer Test

REMARKS:

Top soil	3	3
Yellow Clay	30	33
Yellow Sand	5	38
Blue shale	81	119
Fine Black sand and water	7	126
Water bearing sand and gravel	12	138