

STATE ENGINEER
Salem, Oregon

YAMH Well Record
6452

STATE WELL NO. *5/3W - 9A*
COUNTY *YAMHILL*
APPLICATION NO. *GR-2033*

OWNER: *U. S. Alderman*


MAILING ADDRESS:

LOCATION OF WELL: Owner's No. *#5*

CITY AND STATE: *Dayton, Oregon*

NE 1/4 *NE* 1/4 Sec. *9* T. *5* S., R. *3* W., W.M.

Bearing and distance from section or subdivision corner *845' S. 41° 50' W.*

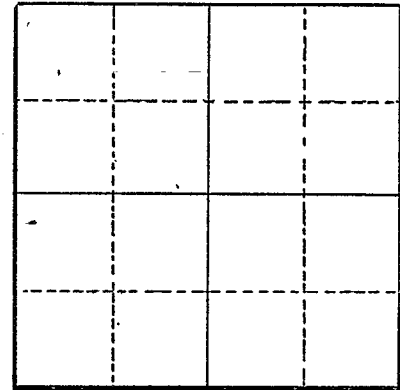

Section

Altitude at well

TYPE OF WELL: *Drilled* Date Constructed *1942*

Depth drilled *77* Depth cased *77*

CASING RECORD:

10-inch

FINISH:

Perforations from 67 to 77

AQUIFERS:

Clay and sand

WATER LEVEL:

5-feet

PUMPING EQUIPMENT: Type *Fairbanks Morse Turbine* H.P. *10*
Capacity *180* G.P.M.

WELL TESTS:

Drawdown ft. after hours G.P.M.

Drawdown ft. after hours G.P.M.

USE OF WATER *Irrigation* Temp. °F. *19*

SOURCE OF INFORMATION *GR-1959*

DRILLER or DIGGER *Fred Wypore, Willamette Drilling Co., Rt. 2, Salem, Oregon*

ADDITIONAL DATA:

Log Water Level Measurements Chemical Analysis Aquifer Test

REMARKS:

