

STATE ENGINEER  
Salem, Oregon

**YAMHILL**  
**6454** **Well Record**


STATE WELL NO. 5/3W-9K  
COUNTY Yamhill  
APPLICATION NO. GR-1873

OWNER: Roy Roth  
MAILING ADDRESS: Route 1, Box 57

LOCATION OF WELL: Owner's No. #1  
CITY AND STATE: Dayton, Oregon

NW ¼ SE ¼ Sec. 9 T. 5 N. S., R. 3 E. W., W.M.

Bearing and distance from section or subdivision corner 2150 feet West and 250 feet South from the E¼ Corner, Section 9.

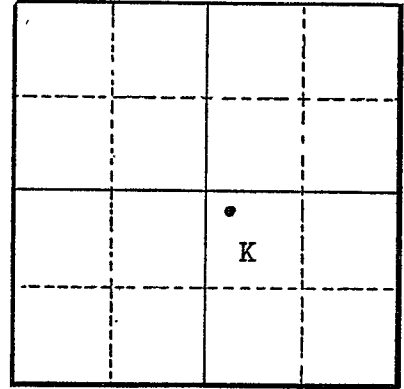

Section 9

Altitude at well

TYPE OF WELL: Drilled Date Constructed May 3, 1953

Depth drilled 106 feet Depth cased 106 feet

CASING RECORD:

6-inch steel casing set from 0 to 106 feet

FINISH:

Torch perforations 12" x ¼" 20' 120 from 86 feet to 106 feet

AQUIFERS:

clay, sand, and gravel

WATER LEVEL:

12 feet

PUMPING EQUIPMENT: Type Sear's Jet Single Phase H.P.

Capacity 5-15 G.P.M.

WELL TESTS:

Drawdown 85 ft. after 15 hours G.P.M.

Drawdown ft. after hours G.P.M.

USE OF WATER Small irrigation Temp. °F., 19

SOURCE OF INFORMATION GR-4082

DRILLER or DIGGER

ADDITIONAL DATA:

Log  Water Level Measurements  Chemical Analysis  Aquifer Test

REMARKS:

top soil	0	2	fine blk sand	56	59
clay	2	22	blue clay	59	82
silty clay	22	29	sandy blue clay	82	86
silt	29	34	course sand and fine gravel	86	105½
blue clay	34	56	silt stone	105½	106