


YAMH  
6463

Well Record

OWNER: Roy E. Stoutenburg MAILING ADDRESS: Route 1, Box 107

LOCATION OF WELL: Owner's No. #1 CITY AND STATE: Dayton, Oregon

NE 1/4 SE 1/4 Sec. 10 T. 5 S., R. 3 W., W.M.  
Bearing and distance from section or subdivision corner  
1300 feet west and 1800 feet north from SE corner of section 10.

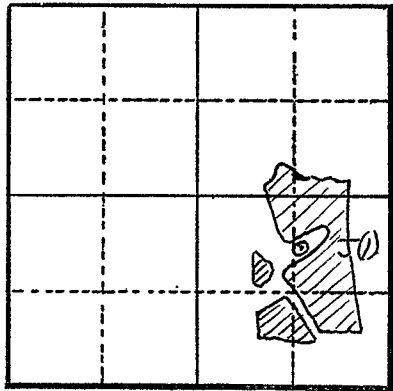

Section 10

Altitude at well 90 feet Interpolated

TYPE OF WELL: Drilled Date Constructed July 1941

Depth drilled 20 Depth cased 20

CASING RECORD:

10 inch casing from 0 to 20 feet,

FINISH:

perforated from 12 to 20 feet, 4x1/2" slots

AQUIFERS:

gravel from 4 to 20 feet,

WATER LEVEL:

4 feet below land surface.

PUMPING EQUIPMENT: Type (Fairbanks-Morse)? H.P. 7 1/2  
Capacity 300 G.P.M.

WELL TESTS:

Drawdown 15 ft. after hours pumping 350 G.P.M.  
Drawdown ft. after hours G.P.M.

USE OF WATER Irrigation 50 acres Temp. °F., 19

SOURCE OF INFORMATION Reg. St. GR-341

DRILLER or DIGGER

ADDITIONAL DATA:

Log yes Water Level Measurements Chemical Analysis Aquifer Test

REMARKS:

soil 0-4  
gravel 4-16