

STATE ENGINEER  
Salem, Oregon

YAMHILL  
6464

# Well Record

STATE WELL NO. 5/3W - 100  
COUNTY YAMHILL  
APPLICATION NO. GR-2035

OWNER: U. S. Alderman


MAILING ADDRESS:

LOCATION OF WELL: Owner's No. #7

CITY AND STATE: Dayton, Oregon

SW 1/4 SE 1/4 Sec. 10 T. 5 N. S, R. 3 E. W., W.M.

Bearing and distance from section or subdivision corner 2336' N. and 58° 20' W.

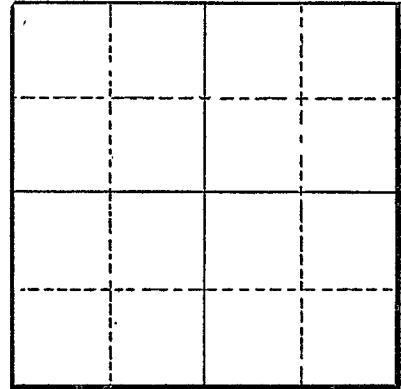

Section

Altitude at well

TYPE OF WELL: Drilled Date Constructed 1954

Depth drilled 150 Depth cased 150

### CASING RECORD:

10-inch

### FINISH:

### AQUIFERS:

Gravel and shale

### WATER LEVEL:

PUMPING EQUIPMENT: Type Fairbanks Morse Turbine H.P. 50  
Capacity 610 G.P.M.

### WELL TESTS:

Drawdown ft. after hours G.P.M.  
Drawdown ft. after hours G.P.M.

USE OF WATER Irrigation Temp. °F., 19

SOURCE OF INFORMATION GR-1961  
DRILLER or DIGGER Fred Wymore, Willamette Drilling Co. Rt. 2, Salem, Oregon

### ADDITIONAL DATA:

Log  Water Level Measurements  Chemical Analysis  Aquifer Test

### REMARKS:

Top soil	2	2
Yellow Clay	32	34
Gravel and shale	5	39
Blue shale	111	150