

STATE ENGINEER
Salem, Oregon

YAMH
6505

Well Record

GR- 1700


STATE WELL NO. 5/3W-16B
COUNTY Yamhill
APPLICATION NO. GR-1753

OWNER: James C. Shelburne
MAILING ADDRESS: Rt. 1, Box 68A

LOCATION OF WELL: Owner's No. CITY AND STATE: Dayton, Oregon

NW 1/4 NE 1/4 Sec. 16 T. 5 S. R. 3 W., W.M.

Bearing and distance from section or subdivision corner 450' E. & 950' S. from N 1/4 cor. Sec. 16

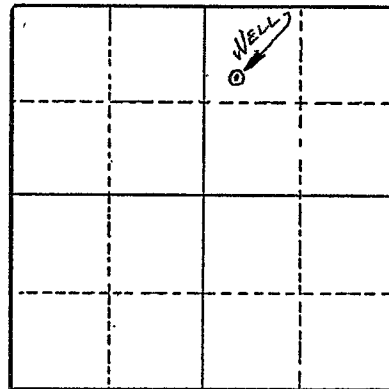

Section 16

Altitude at well 500'

TYPE OF WELL: Drilled Date Constructed 1953

Depth drilled 124' Depth cased ?

CASING RECORD:

8"

FINISH:

AQUIFERS:

WATER LEVEL:

30'

PUMPING EQUIPMENT: Type F. M. H.P. 10

Capacity 250 G.P.M.

WELL TESTS:

Drawdown 100 ft. after 250 hours G.P.M.

Drawdown ft. after hours G.P.M.

USE OF WATER Irrigation Temp. °F. 19

SOURCE OF INFORMATION GR Record

DRILLER or DIGGER Wilcox

ADDITIONAL DATA:

Log N.A. Water Level Measurements Chemical Analysis Aquifer Test

REMARKS:

Irrigation of 23 acres.