

STATE ENGINEER  
Salem, Oregon

YAMH  
6548

# Well Record

STATE WELL NO. 5/3W-20J  
COUNTY Yamhill  
APPLICATION NO. GR-1426

GR- 1380

OWNER: Kinley K. Adams


MAILING ADDRESS: 1445 Beaumont Dr.

LOCATION OF WELL: Owner's No. #1

CITY AND STATE: Salem, Oregon

NE 1/4 SE 1/4 Sec. 20 T. 5 S., R. 3 W., W.M.

Bearing and distance from section or subdivision corner 2580' N. & 1070' W. from SE cor. Sec. 20

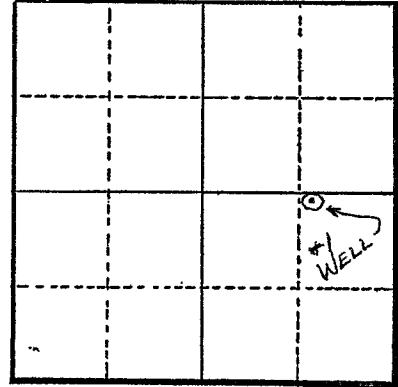

Section 20

Altitude at well

TYPE OF WELL: Drilled Date Constructed 1948

Depth drilled 212' Depth cased 212'

### CASING RECORD:

8"

### FINISH:

Mills knife perforations from 100' to 120'

### AQUIFERS:

### WATER LEVEL:

70'

PUMPING EQUIPMENT: Type F. M. Pomona turbine H.P. 20  
Capacity 400 G.P.M.

### WELL TESTS:

Drawdown ft. after hours G.P.M.

Drawdown ft. after hours G.P.M.

USE OF WATER Irrigation Temp. °F. 19

SOURCE OF INFORMATION GR Record

DRILLER or DIGGER Sneed & Son

### ADDITIONAL DATA:

Log N.A. Water Level Measurements Chemical Analysis Aquifer Test

### REMARKS:

Irrigation of 80 acres.