

STATE ENGINEER
Salem, Oregon

YAMH
6561

Well Record


STATE WELL NO. 5/3W-21
COUNTY YAMHILL
APPLICATION NO. GR-2571

OWNER: Robert A. Magee MAILING ADDRESS: Rt. 1, Box 147

LOCATION OF WELL: Owner's No. _____ CITY AND STATE: Dayton, Oregon

SE $\frac{1}{4}$ NE $\frac{1}{4}$ NW $\frac{1}{4}$ Sec. 21 T. 5 S., R. 3 W., W.M.

Bearing and distance from section or subdivision corner 1228' S. 235' W.

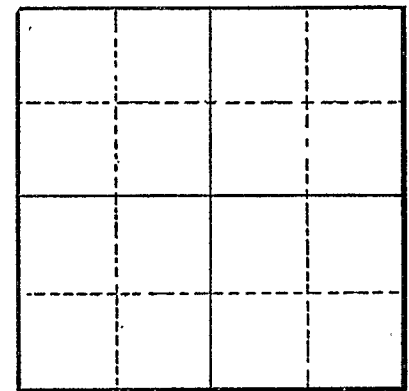

Section _____

Altitude at well _____

TYPE OF WELL: Drilled Date Constructed 1950

Depth drilled 130 Depth cased 130

CASING RECORD:

8-inch

FINISH:

Yes - mills knife

AQUIFERS:

Sands and gravels

WATER LEVEL:

39-feet

PUMPING EQUIPMENT: Type Berkeley Turbine, Berkeley Centrifugal H.P. 7 $\frac{1}{2}$, 10
Capacity _____ G.P.M.

WELL TESTS:

Drawdown 85 ft. after _____ hours Pumping 170 G.P.M.
Drawdown 100 ft. after _____ hours Pumping 200 G.P.M.

USE OF WATER Irrigation Temp. _____ °F. _____, 19_____

SOURCE OF INFORMATION GR-2430

DRILLER or DIGGER Fred G. Wymore, Salem, Oregon

ADDITIONAL DATA:

Log Water Level Measurements _____ Chemical Analysis _____ Aquifer Test _____

REMARKS:

Sands and gravels