

STATE ENGINEER  
Salem, Oregon

YAMH  
6565

OBSERVATION WELL  
Well Record

STATE WELL NO. 5/3W-21 c(1)  
COUNTY Yamhill  
APPLICATION NO. GR-120

OWNER: Louie W. Magee


MAILING ADDRESS: Rt 1, Box 145

LOCATION OF WELL: Owner's No. 1

CITY AND STATE: Dayton, Oregon

NE 1/4 NW 1/4 Sec. 21 T. 5 S., R. 3 W., W.M.

Bearing and distance from section or subdivision corner 2255 feet S66°E of NW corner of section - 21.

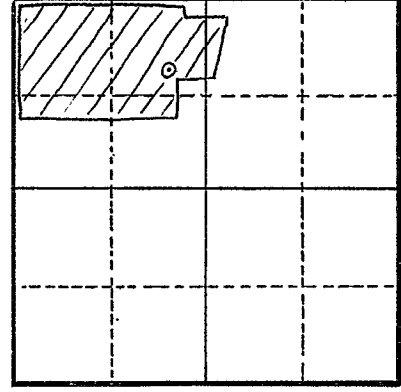

Section 21

Altitude at well 160 feet Interpolated

TYPE OF WELL: Drilled Date Constructed 5/7/49

Depth drilled 234 Depth cased 234

CASING RECORD:

8" — inch casing set from 0 to 234 feet.

FINISH:

Mills knife slots from 112 feet to 124 feet.  
222 " to 234 feet.

AQUIFERS:

un known.

WATER LEVEL:

25 feet below land surface. May 1949

PUMPING EQUIPMENT: Type Peerless Turbine H.P. 15  
Capacity 300 G.P.M.

WELL TESTS:

Drawdown 40 ft. after 250 hours \*Dry after 4-5 Days pumping G.P.M.  
Drawdown ft. after hours G.P.M.

USE OF WATER Irrigation 83 acres Temp. °F., 19

SOURCE OF INFORMATION Registration Statement GR-120

DRILLER or DIGGER Fred Wymore

ADDITIONAL DATA:

Log No. Water Level Measurements Chemical Analysis Aquifer Test

REMARKS: