

STATE ENGINEER
Salem, Oregon

YAMH
6572

OBSERVATION WELL
Well Record

STATE WELL NO. 53W-2/1A
COUNTY Yamhill
APPLICATION NO. G.R. 67

OWNER: Fred. C. Stockhoff


MAILING ADDRESS: R.F.D. #1

LOCATION OF WELL: Owner's No. 1

CITY AND STATE: Dayton, Oregon

SW 1/4 SW 1/4 Sec. 21 T. 5 S., R. 3 W., W.M.

Bearing and distance from section or subdivision corner
3150 feet east of NW corner Mark Sawyer
D.L.C. and SW corner Jason Peters D.L.C.
or 1260 feet east from SW corner of section
21

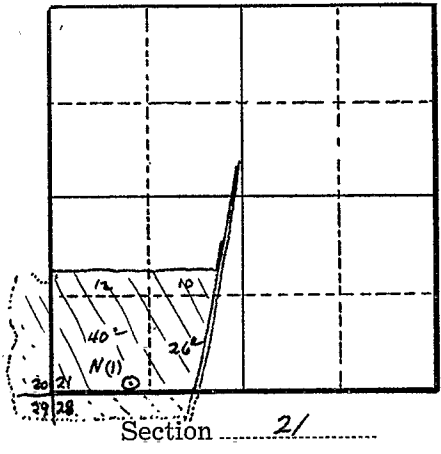

Altitude at well 150 feet Interpolated

TYPE OF WELL: Drilled Date Constructed Mar. 1952

Depth drilled 138' Depth cased 138'

CASING RECORD:

10-inch casing set from 0 to 138 feet.

FINISH:

8 perforations per foot (1/8" x 1") from 98' to 138 feet.

AQUIFERS:

Sand and gravel from 98 to 138 feet.

WATER LEVEL:

20 feet below land surface April 1952 (60 feet in Summer)

PUMPING EQUIPMENT: Type Pomona 16 1/2 x 6 discharge head H.P. 40
Capacity 550 G.P.M.

WELL TESTS:

Drawdown 22 ft. after 600 hours G.P.M.
Drawdown 40 ft. after 800 hours G.P.M.

USE OF WATER Irrigation 157 acres Temp. °F., 19

SOURCE OF INFORMATION Registration Statement G.R. 67

DRILLER or DIGGER Wilcox Co. John J. Jensen Driller

ADDITIONAL DATA:
Log Water Level Measurements Chemical Analysis Aquifer Test

REMARKS: