

STATE ENGINEER
Salem, Oregon

YAMH 6581
Well Record


STATE WELL NO. 53w-22.80
COUNTY Yamhill
APPLICATION NO. GR-210

OWNER: Dick Rockhill MAILING ADDRESS: Rt 1, Box 123

LOCATION OF WELL: Owner's No. #1 CITY AND STATE: Dayton, Oregon

NW 1/4 NE 1/4 Sec. 22 T. 5 S., R. 3 W., W.M.

Bearing and distance from section or subdivision corner 2000 feet west and 630 feet south from NE corner of section 22.

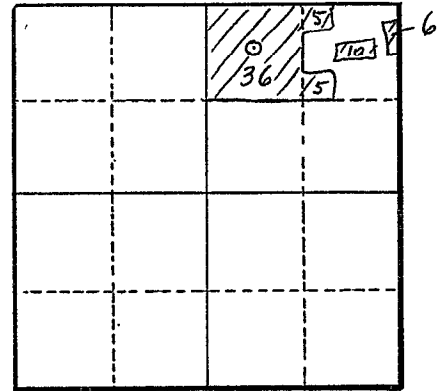

Section 22

Altitude at well +100 feet Interpolated

TYPE OF WELL: Drilled Date Constructed 1939

Depth drilled 30 Depth cased 30

CASING RECORD:

8 inch steel casing from 0 to 30 feet.

FINISH:

perforated between 20 & 30 feet.

AQUIFERS:

sand & gravel from 12 to 30 feet.

WATER LEVEL:

15 feet below land surface. Aug, '56

PUMPING EQUIPMENT: Type centrifugal H.P. 20
Capacity 400 G.P.M.

WELL TESTS:

Drawdown ft. after hours G.P.M.
Drawdown ft. after hours G.P.M.

USE OF WATER Irrigation 62 acres Temp. °F., 19.....

SOURCE OF INFORMATION Registration statement GR-210

DRILLER or DIGGER - Huffman Bros. Newberg, Oregon

ADDITIONAL DATA:

Log Water Level Measurements Chemical Analysis Aquifer Test

REMARKS: ✓

soil 0 to 12'
sand 12 - 26
gravel 26 to 30

WELL IDENTIFICATION FORM

YAMHILL 6581

CURRENT WELL OWNER:

Owner's Well Number: _____

Name: ROGER & GAYLE HOLDERBY

868-7701

RECEIVED

JUL 30 1996

Mailing Address: 21841 GRAND ISLAND LOOP

WATER RESOURCES DEPT
SALEM, OREGON

City: DAYTON

State: OR

Zip: 97117

If a well report is available for this well, please attach a copy of it to this form and return. It is not necessary for you to complete the remainder of the form if the well report is attached. If a well report is not available, please complete the remainder of the form to the best of your ability.

WELL LOCATION:

County: YAMHILL ⁶⁵⁸¹ Latitude: _____ Longitude: _____

Township: 5 N or S, Range: 3 E or W Section: 22 1/4 1/4

Tax Lot Number: 00100

Street Address of Well (if different from above): _____

WELL INFORMATION:

Start Card Number: _____ Approx. Construction Date: 1946

Well Constructor: _____

Name of Owner at Time of Construction: LULA A. ROCKHILL & C.A. ROCKHILL

Well Depth (in feet): _____ Static Water Level (in feet): _____

Diameter of Exposed Well Casing (in inches): _____

Does this well have a formal water right associated with it? Yes: _____ No: _____ If yes:

Application #: _____ Permit #: _____ Certificate #: _____

Please Return Completed Form to: **Oregon Water Resources Department
158 12th Street NE
Salem, OR 97310**

(Office use only)

Well Identification Number: LP 6904