

STATE ENGINEER  
Salem, Oregon

YAMH  
6582

# Well Record

STATE WELL NO. 5/3W-22C  
COUNTY Yamhill  
APPLICATION NO. GR-3320

OWNER: Wilbur Chandler


MAILING ADDRESS: Route 1, Box 122

LOCATION OF WELL: Owner's No.

CITY AND STATE: Dayton, Oregon

NE 1/4 NW 1/4 Sec. 22 T. 5 S., R. 3 W., W.M.

Bearing and distance from section or subdivision  
corner S 54° W. 1050'

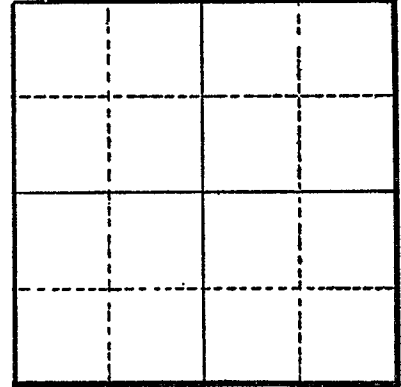

Section

Altitude at well

TYPE OF WELL: drilled Date Constructed 1939

Depth drilled 24' Depth cased 24'

### CASING RECORD:

8"

### FINISH:

slots 1/2" x 5" from 18 to 23

### AQUIFERS:

Topsoil, Sand, Gravel

### WATER LEVEL:

10'

PUMPING EQUIPMENT: Type Fairbanks Morse H.P. 10  
Capacity 240 G.P.M.

### WELL TESTS:

Drawdown 8 ft. after hours pumping 240 G.P.M.  
Drawdown ft. after hours G.P.M.

USE OF WATER Irrigation Temp. °F., 19

SOURCE OF INFORMATION GR-3081

DRILLER or DIGGER

### ADDITIONAL DATA:

Log  Water Level Measurements  Chemical Analysis  Aquifer Test

### REMARKS:

topsoil 10 10  
sand 8 18  
gravel 6 24