

STATE ENGINEER  
Salem, Oregon

YAMH  
6586

# Well Record

STATE WELL NO. 5/3W-22 G  
COUNTY Yamhill  
APPLICATION NO. GR-1648

OWNER: Jacob J. Tompkins


MAILING ADDRESS: Route 1,

LOCATION OF WELL: Owner's No.

CITY AND STATE: Dayton, Oregon

SW 1/4 NE 1/4 Sec. 22 T. 5 N. S., R. 3 E. W., W.M.

Bearing and distance from section or subdivision corner 1350' S. & 2490' W. of NE corner

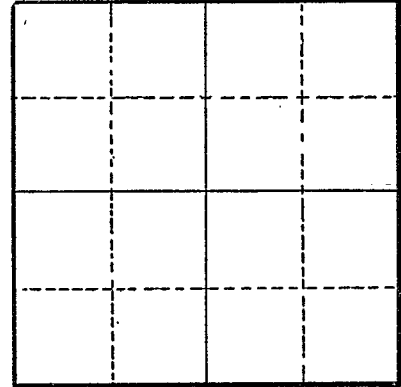

Section 22

Altitude at well

TYPE OF WELL: Drilled Date Constructed Oct. '55

Depth drilled 159' Depth cased 159

### CASING RECORD:

10-inch from 0 to 100 feet  
6-inch from 90 to 159 feet

### FINISH:

Perforated 5 per foot, one foot long of 30

### AQUIFERS:

### WATER LEVEL:

0

PUMPING EQUIPMENT: Type Berkely Shaft, Deming Power Head H.P. 7 1/2  
Capacity 500 G.P.M.

### WELL TESTS:

Drawdown 55 ft. after 900 hours G.P.M.  
Drawdown ft. after hours G.P.M.

USE OF WATER Irrigation Temp. °F., 19.

SOURCE OF INFORMATION GR-1648

DRILLER or DIGGER

### ADDITIONAL DATA:

Log Water Level Measurements Chemical Analysis Aquifer Test

### REMARKS: