

STATE ENGINEER
Salem, Oregon

YAMH
6588 Well Record


STATE WELL NO. 5/34-22 J(1)
COUNTY Yamhill
APPLICATION NO. GR-17

OWNER: Dale Fowler MAILING ADDRESS:

LOCATION OF WELL: Owner's No. #3 CITY AND STATE: Dayton, Oregon

NE 1/4 SE 1/4 Sec. 22 T. 5 S. R. 3 W., W.M.

Bearing and distance from section or subdivision corner 192 feet south and 300 feet west from east 1/4 corner of section 22.

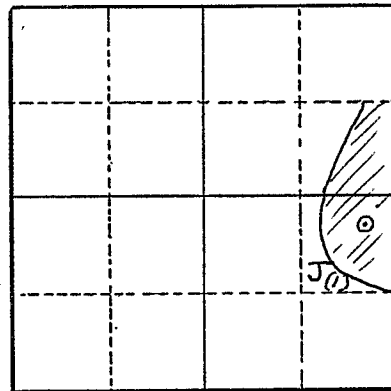

Section 22

Altitude at well 50 feet Interpolated

TYPE OF WELL: Drilled Date Constructed 1943

Depth drilled 40' Depth cased - 40'

CASING RECORD:

8-inch casing set from 0 to 40 feet.

FINISH:

None

AQUIFERS:

WATER LEVEL:

6 feet below land surface 1943

PUMPING EQUIPMENT: Type Fairbanks Morse 3" H.P. 25
Capacity 600 G.P.M.

WELL TESTS:

Drawdown 18' ft. after 750 hours G.P.M.
Drawdown ft. after hours G.P.M.

USE OF WATER Irrigation 88 acres Temp. °F., 19
SOURCE OF INFORMATION Registration Statement GR-17
DRILLER or DIGGER -

ADDITIONAL DATA:

Log ☒ Water Level Measurements ☒ Chemical Analysis ☐ Aquifer Test ☐

REMARKS:

Log - 0-6' loam, sandy 6' thick
6'-40' gravels 34' "