

STATE ENGINEER
Salem, Oregon

Well Record

STATE WELL NO. 5/3W-22J
COUNTY Yamhill
APPLICATION NO. GR-1785

GR-1727

OWNER: Dan Tompkins

MAILING

ADDRESS: Rt. 1

LOCATION OF WELL: Owner's No. #1

CITY AND

STATE: Dayton, Oregon

NE 1/4 SE 1/4 Sec. 22 T. 5 S., R. 3 W., W.M.


Bearing and distance from section or subdivision

corner 1510' N. & 1130' W. from SE cor. Sec. 22

Altitude at well 100'

TYPE OF WELL: Drilled Date Constructed 1942

Depth drilled 55' Depth cased 55'

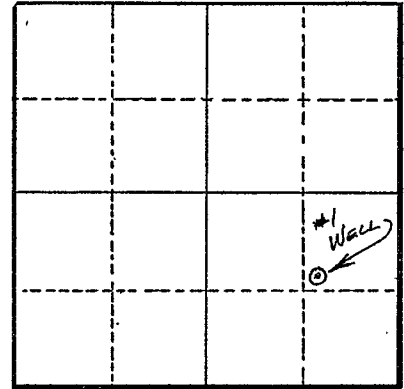

Section 22

CASING RECORD:

8"

FINISH:

Perforated with 8" torch cuts (12) around casing from 46 to 54 ft.

AQUIFERS:

WATER LEVEL:

12'

PUMPING EQUIPMENT: Type Berkeley 5" line shaft turbine H.P. 7 1/2
Capacity 120 G.P.M.

WELL TESTS:

Drawdown 43 ft. after 105 hours G.P.M.

Drawdown ft. after hours G.P.M.

USE OF WATER Irrigation Temp. °F. 19

SOURCE OF INFORMATION GR Record

DRILLER or DIGGER Fred Wymore

ADDITIONAL DATA:

Log N.A. Water Level Measurements Chemical Analysis Aquifer Test

REMARKS:

Irrigation of 17 acres.