

STATE ENGINEER
Salem, Oregon

YAMH
6591

Well Record

GR- 1728


STATE WELL NO. 5/3W-22K
COUNTY Yamhill
APPLICATION NO. GR- 1786

OWNER: Dan Tompkins
MAILING ADDRESS: Rt. 1

LOCATION OF WELL: Owner's No. #2
CITY AND STATE: Dayton, Oregon

NW 1/4 SE 1/4 Sec. 22 T. 5 S., R. 3 W., W.M.

Bearing and distance from section or subdivision
corner 2170' N. & 1880' W. from SE cor. Sec. 22

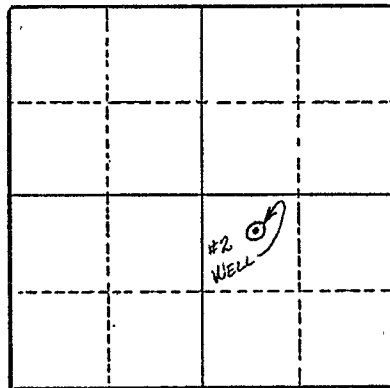

Section 22

Altitude at well 100'

TYPE OF WELL: Drilled Date Constructed 1939

Depth drilled 55' Depth cased 55'

CASING RECORD:
8"

FINISH:

Casing perforated for 8 feet - 8" long, 12 per foot from 40 to 48 ft.

AQUIFERS:

WATER LEVEL:

14'

PUMPING EQUIPMENT: Type F. M. 3" x 4" Cent. H.P. 20
Capacity 250 G.P.M.

WELL TESTS:

Drawdown 24 ft. after 224 hours G.P.M.

Drawdown ft. after hours G.P.M.

USE OF WATER Irrigation Temp. °F., 19

SOURCE OF INFORMATION GR Record

DRILLER or DIGGER Fred Wymore

ADDITIONAL DATA:

Log N.A. Water Level Measurements Chemical Analysis Aquifer Test

REMARKS:

Irrigation of 33.7 acres.