

STATE ENGINEER
Salem, Oregon

YAMH
6594

Well Record

STATE WELL NO. 5/3W-22R(1)
COUNTY Yamhill
APPLICATION NO. GR-780

OWNER: H. B. Steingrube


MAILING ADDRESS: Rt. 1 Box 92

LOCATION OF WELL: Owner's No. #3

CITY AND STATE: Dayton, Oregon

SE 1/4 SE 1/4 Sec. 22 T. 5 N. S., R. 3 W., W.M.

Bearing and distance from section or subdivision corner 800' N. & 1100' W of common corners sections 22, 23, 26, and 27.

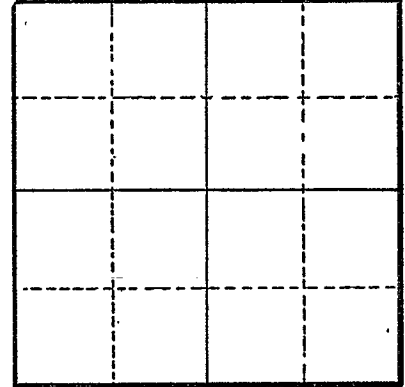

Section 22

Altitude at well 100 ft.

TYPE OF WELL: Drilled Date Constructed 1938

Depth drilled 20' Depth cased 20'

CASING RECORD:

8 inch

FINISH:

12' of perforations from 8' to 20'

AQUIFERS:

WATER LEVEL:

1 foot

PUMPING EQUIPMENT: Type Fairbanks Morse H.P. 40

Capacity 600 G.P.M.

WELL TESTS:

Drawdown 19 ft. after 600 hours G.P.M.

Drawdown ft. after hours G.P.M.

USE OF WATER Irrigation Temp. °F. 19

SOURCE OF INFORMATION GR-780

DRILLER or DIGGER

ADDITIONAL DATA:

Log Below Water Level Measurements Chemical Analysis Aquifer Test

REMARKS:

Earth 0 to 10'