

STATE ENGINEER
Salem, Oregon


YAMH Well Record
6595

STATE WELL NO. 53w-23
COUNTY Yamhill
APPLICATION NO. GR-750

OWNER: Arnold E. Hildebrandt MAILING ADDRESS: Grand Island

LOCATION OF WELL: Owner's No. CITY AND STATE: Dayton, Oregon

NW 1/4 NW 1/4 Sec. 23 T. 5 S., R. 3 W., W.M.
Bearing and distance from section or subdivision corner 670' S. & 1150' E. of NW 1/4 corner of section 23.

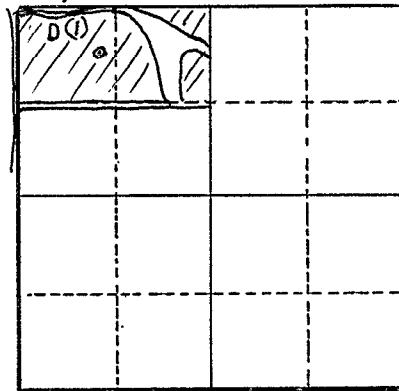

Section 23

Altitude at well 105 feet Interpolated

TYPE OF WELL: Dug Date Constructed 1937

Depth drilled 60 Depth cased None

CASING RECORD:
None

FINISH:

AQUIFERS:

WATER LEVEL: 20 feet

PUMPING EQUIPMENT: Type F.M. cent. 3 in. H.P. 20
Capacity 436 G.P.M.

WELL TESTS:
Drawdown Unlimited ft. after _____ hours _____ G.P.M.
Drawdown _____ ft. after _____ hours _____ G.P.M.

USE OF WATER Irrigation Temp. _____ °F. _____, 19____

SOURCE OF INFORMATION GR-750

DRILLER or DIGGER _____

ADDITIONAL DATA:
Log Below Water Level Measurements _____ Chemical Analysis _____ Aquifer Test _____

REMARKS:
Gravel from 0' to 60'