

STATE ENGINEER
Salem, Oregon

YAMH Well Record
6596

STATE WELL NO. 5/3W - 23A
COUNTY YAMHILL
APPLICATION NO. GR-2036

OWNER: U. S. Alderman


MAILING ADDRESS:

LOCATION OF WELL: Owner's No. #8

CITY AND STATE: Dayton, Oregon

NE 1/4 NE 1/4 Sec. 23 T. 5 N. S., R. 3 W. W.M.

Bearing and distance from section or subdivision corner 1089' S. 53° 59' W.

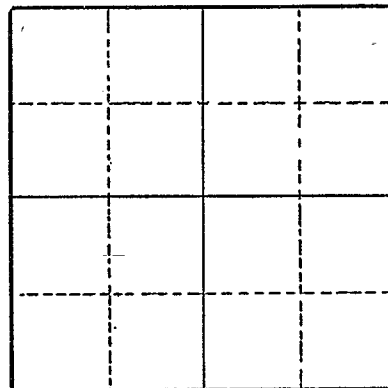

Section

Altitude at well

TYPE OF WELL: Drilled Date Constructed 1942

Depth drilled 29 Depth cased 16 29

CASING RECORD:

20-inch
15-inch

FINISH:

Perforations from 16 to 29

AQUIFERS:

Sand, gravel, clay and soil

WATER LEVEL:

5-feet

PUMPING EQUIPMENT: Type Fairbanks Morse Centrifugal H.P. 90
Capacity 420 G.P.M.

WELL TESTS:

Drawdown ft. after hours G.P.M.
Drawdown ft. after hours G.P.M.

USE OF WATER Irrigation Temp. °F., 19.....

SOURCE OF INFORMATION GR-1962
DRILLER or DIGGER Fred Wymore, Willamette Drilling Co., Rt. 2, Salem, Oregon

ADDITIONAL DATA:

Log X Water Level Measurements Chemical Analysis Aquifer Test

REMARKS:

Top soil 2 2
Blue clay 14 16
Water bearing sand and gravel 13 29