

STATE ENGINEER
Salem, Oregon

YAMH 6707 Well Record

STATE WELL NO. 5/3W-23B
COUNTY Yamhill
APPLICATION NO. GR-3746

OWNER: Ronald M. Finnican

MAILING

ADDRESS: R.F.D. 1

LOCATION OF WELL: Owner's No.


CITY AND

STATE: Dayton, Oregon

NW 1/4 NE 1/4 Sec. 23 T. 5 S., R. 3 W., W.M.

Bearing and distance from section or subdivision

corner 762' S. & 433' E. of N 1/4 Cor. Sec. 23

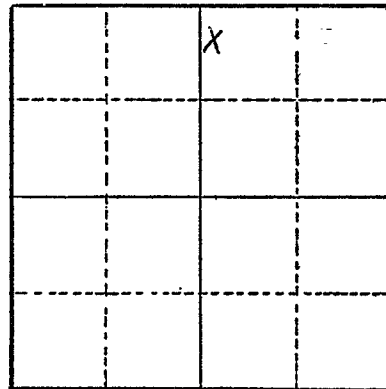

Section 23

Altitude at well

TYPE OF WELL: Drilled Date Constructed May, 1944

Depth drilled 32 feet Depth cased 32 feet

CASING RECORD:

12 inch casing set to 32 feet

FINISH:

8 perforations per foot 1/4" by 3" from 12 feet to 32 feet

AQUIFERS:

WATER LEVEL:

3 feet below surface

PUMPING EQUIPMENT: Type F. M. centrifugal H.P. 20
Capacity 400 G.P.M.

WELL TESTS:

Drawdown 28 ft. after hours 325 G.P.M.

Drawdown 31 ft. after hours 350 G.P.M.

USE OF WATER Irrigation Temp. °F. 19

SOURCE OF INFORMATION Well Registration Statement

DRILLER or DIGGER Fred Wymore

ADDITIONAL DATA:

Log X Water Level Measurements Chemical Analysis Aquifer Test

REMARKS:

Log:

Dirt and clay

Blue sand water

Gravel water bearing

Thickness

6

2

24