

STATE ENGINEER
Salem, Oregon

YAMH Well Record
6708

STATE WELL NO. 5/3W-23E
COUNTY Yamhill
APPLICATION NO. GR-1762

OWNER: Victor Scoggan

MAILING

ADDRESS: Rt. 1

LOCATION OF WELL: Owner's No. #2

CITY AND

STATE: Dayton, Oregon

SW 1/4 NW 1/4 Sec. 23 T. 5 S. R. 3 W., W.M.


Bearing and distance from section or subdivision

corner 337' E. & 105' N. from W 1/4 cor. Sec. 23

Altitude at well 80'

TYPE OF WELL: Drilled Date Constructed 1955

Depth drilled 43' Depth cased 43'

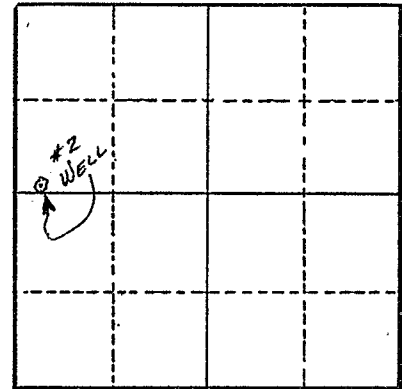

Section 23

CASING RECORD:

30" concrete from 0 to 8 ft.

12" steel from 8 to 43 ft.

FINISH:

Perforated with Mills slots 3/8" x 2" (10 rows of 12/row) from 17 to 24 ft.

Torch perforations 1/2" x 6" (8 rows of 12/row) from 24 to 43 ft.

AQUIFERS:

WATER LEVEL:

10'

PUMPING EQUIPMENT: Type Pacific 3" Cent. H.P. 15
Capacity 350 G.P.M.

WELL TESTS:

Drawdown ft. after hours G.P.M.

Drawdown ft. after hours G.P.M.

USE OF WATER Irrigation Temp. °F. 19

SOURCE OF INFORMATION GR Record

DRILLER or DIGGER Willamette Drilling Co.

ADDITIONAL DATA:

Log Water Level Measurements Chemical Analysis Aquifer Test

REMARKS:

Log: Clay & sand 0 to 14 ft.
Blue sand & gravel 14 to 43 ft.

Irrigation of 38.2 acres.