

STATE ENGINEER
Salem, Oregon

Well Record

STATE WELL NO. 5/3W-23E
COUNTY Yamhill
APPLICATION NO. GR-1761

GR-1709

OWNER: Victor Scoggan

MAILING

ADDRESS: Rt. 1

LOCATION OF WELL: Owner's No. #1

CITY AND

STATE: Dayton, Oregon

SW 1/4 NW 1/4 Sec. 23 T. 5 S. R. 3 W., W.M.


Bearing and distance from section or subdivision

corner 310' E. & 105' N. from W 1/4 cor. Sec. 23

Altitude at well 80'

TYPE OF WELL: Drilled Date Constructed 1938

Depth drilled 29' Depth cased 29'

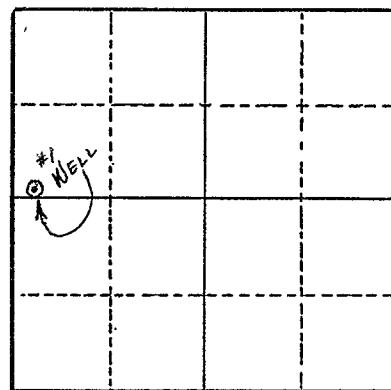

Section 23

CASING RECORD:

30" concrete from 0 to 14 ft.

15" steel from 14 to 20 ft.

12" steel from 20 to 29 ft.

FINISH:

Perforated with 1/2" x 4" slots (6/ft.) from 20 to 29 ft.

AQUIFERS:

WATER LEVEL:

10'

PUMPING EQUIPMENT: Type Pacific 3" Cent. H.P. 15

Capacity 350 G.P.M.

WELL TESTS:

Drawdown ft. after hours G.P.M.

Drawdown ft. after hours G.P.M.

USE OF WATER Irrigation Temp. °F. 19

SOURCE OF INFORMATION GR Record

DRILLER or DIGGER Willamette Drilling Co.

ADDITIONAL DATA:

Log Water Level Measurements Chemical Analysis Aquifer Test

REMARKS:

Log: Clay & sand

0 to 14 ft.

Blue sand & gravel

14 to 29 ft.

Irrigation of 38.2 acres.