

STATE ENGINEER
Salem, Oregon

YAMH
67/2

Well Record

STATE WELL NO. 5/3W-23J
COUNTY Yamhill
APPLICATION NO. GR-1541

GR- 1484

OWNER: Harvey Ewert


MAILING ADDRESS: Rt. 1, Box 144

LOCATION OF WELL: Owner's No. #2

CITY AND STATE: Dayton, Oregon

NE 1/4 SE 1/4 Sec. 23 T. 5 S., R. 3 W., W.M.

Bearing and distance from section or subdivision corner 650' W. & 1750' N. from SE cor. Sec. 23

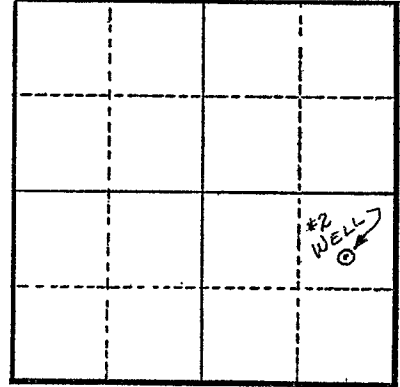

Section 23

Altitude at well

TYPE OF WELL: Drilled Date Constructed 1928?

Depth drilled 25' Depth cased 25'

CASING RECORD:
10"

FINISH:

AQUIFERS:

WATER LEVEL:
5'

PUMPING EQUIPMENT: Type 2" x 2 1/2" H.P. 10
Capacity 200 G.P.M.

WELL TESTS:
Drawdown 15 ft. after 150 hours G.P.M.
Drawdown ft. after hours G.P.M.

USE OF WATER Irrigation Temp. °F. 19

SOURCE OF INFORMATION GR Record

DRILLER or DIGGER

ADDITIONAL DATA:

Log N.A. Water Level Measurements Chemical Analysis Aquifer Test

REMARKS:

Irrigation of 26 acres.