

STATE ENGINEER  
Salem, Oregon

YAMHILL  
6713

# Well Record

STATE WELL NO. 5/3W-23J  
COUNTY Yamhill  
APPLICATION NO. GR-1542

GR- 1485

OWNER: Harvey Ewert


MAILING ADDRESS: Rt. 1, Box 144

LOCATION OF WELL: Owner's No. #1

CITY AND STATE: Dayton, Oregon

NE 1/4 SE 1/4 Sec. 23 T. 5 S., R. 3 W., W.M.

Bearing and distance from section or subdivision corner 650' W. & 2500' N. from SE cor. Sec. 23

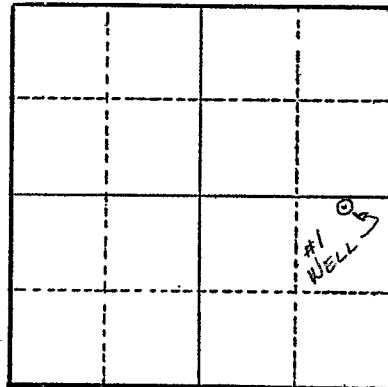

Section 23

Altitude at well

TYPE OF WELL: Drilled Date Constructed 1928?

Depth drilled 20' Depth cased 20'

### CASING RECORD:

10"

### FINISH:

### AQUIFERS:

### WATER LEVEL:

10'

PUMPING EQUIPMENT: Type 3" x 3 1/2" F. M. H.P. 15  
Capacity 300 G.P.M.

### WELL TESTS:

Drawdown 5 ft. after 300 hours G.P.M.

Drawdown ft. after hours G.P.M.

USE OF WATER Irrigation Temp. °F. 19

SOURCE OF INFORMATION GR Record

DRILLER or DIGGER

### ADDITIONAL DATA:

Log N.A. Water Level Measurements Chemical Analysis Aquifer Test

### REMARKS:

Irrigation of 24 acres.