

STATE ENGINEER
Salem, Oregon

YAMHILL
6714

Well Record

STATE WELL NO. ...5/3W-23K...
COUNTY ...Yamhill...
APPLICATION NO. GR-3155

OWNER: Curtis A. Douglas


MAILING ADDRESS: Rt. 1, Box 143

LOCATION OF WELL: Owner's No. _____

CITY AND STATE: Dayton, Oregon

NW 1/4 SE 1/4 Sec. 23 T. 5 N. S, R. 3 E. W., W.M.

Bearing and distance from section or subdivision
corner 1900' West and 2250' N.

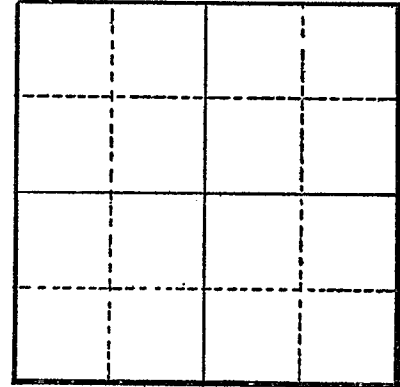

Section

Altitude at well _____

TYPE OF WELL: Drilled Date Constructed 1948

Depth drilled 22' Depth cased 22'

CASING RECORD:

12"

FINISH:

Perforated 10 to 22'

AQUIFERS:

Sandy Loam topsoil, gravel and sand

WATER LEVEL:

5'

PUMPING EQUIPMENT: Type 3" F. M.: Centrifugal H.P. 15
Capacity 300 G.P.M.

WELL TESTS:

Drawdown ft. after hours G.P.M.
Drawdown ft. after hours G.P.M.

USE OF WATER Irrigation Temp. °F., 19

SOURCE OF INFORMATION GR-2961

DRILLER or DIGGER Fred Wymore, Salem, Oregon

ADDITIONAL DATA:

Log X Water Level Measurements Chemical Analysis Aquifer Test

REMARKS:

Sandy Loam Topsoil 3' to 3'
Tight Packed gravel & Sand water-bearing 19' to 22'