

STATE ENGINEER  
Salem, Oregon

# Well Record

STATE WELL NO. 5/3W-23L  
COUNTY Yamhill  
APPLICATION NO. GR-3567


*YAMH  
6715*

OWNER: Cecil LeRoy Will MAILING ADDRESS: Route 1, Box 141

LOCATION OF WELL: Owner's No. \_\_\_\_\_ CITY AND STATE: Dayton, Oregon

N E  
..NE... $\frac{1}{4}$ ..SW... $\frac{1}{4}$  Sec. 23 T. 5 S., R. 3 W., W.M.

Bearing and distance from section or subdivision  
corner 1095 ft. S. and 720 ft. W. of center of  
Sec. 23

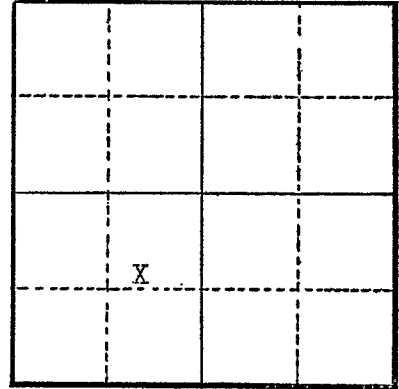

Section 23

Altitude at well \_\_\_\_\_

TYPE OF WELL: Drilled Date Constructed Apr., 1939

Depth drilled 34 ft. Depth cased 34 ft.

### CASING RECORD:

30 inch concrete tile casing from 0 to 20 feet  
20 inch steel casing from 20 to 26 feet  
18 inch steel casing from 26 to 34 feet

### FINISH:

Steel casing slotted  $\frac{1}{2}$  x 6", 10 per foot from 20 ft. to 34 ft.

### AQUIFERS:

sediments

### WATER LEVEL:

8 feet below surface

PUMPING EQUIPMENT: Type Cornell centrifugal electric H.P. 15  
Capacity 275 G.P.M.

### WELL TESTS:

Drawdown 20 ft. after \_\_\_\_\_ hours 300 G.P.M.  
Drawdown 10 ft. after \_\_\_\_\_ hours 200 G.P.M.

USE OF WATER Irrigation Temp. \_\_\_\_\_ °F., 19

SOURCE OF INFORMATION Well Registration Statement

DRILLER or DIGGER Wymore

### ADDITIONAL DATA:

Log X Water Level Measurements \_\_\_\_\_ Chemical Analysis \_\_\_\_\_ Aquifer Test \_\_\_\_\_

### REMARKS:

Log:	Thickness	Depth to Bottom
Silt loam	0	9
Mixed sand & gravel	25	34