

STATE ENGINEER
Salem, Oregon

YAMH Well Record

STATE WELL NO. 5/3W-23 M19
COUNTY Yamhill
APPLICATION NO. GR-17

OWNER: Dale Fowler

MAILING
ADDRESS:


LOCATION OF WELL: Owner's No. 4

CITY AND
STATE:

Dayton, Oregon

NW 1/4 SW 1/4 Sec. 23 T. 5 S., R. 3 W., W.M.

Bearing and distance from section or subdivision
corner 10 feet south and 405 feet east
from E 1/4 corner Section 22.

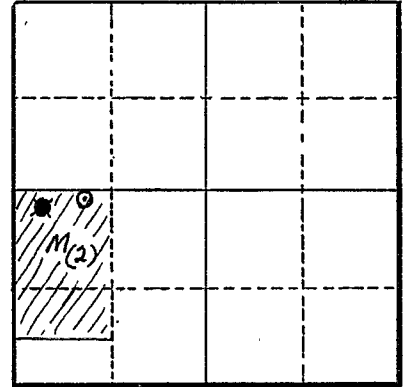

Section 23

Altitude at well 50 feet Interpolated

TYPE OF WELL: Drilled Date Constructed 1940

Depth drilled 50' Depth cased 50'

CASING RECORD:

8-inch casing set from 0 to 50 feet.

FINISH:

None

AQUIFERS:

sand, from 6' to 50 feet

WATER LEVEL:

8 feet below land surface - 1943

PUMPING EQUIPMENT: Type Pacific centrifugal 3" H.P. 25
Capacity 600 G.P.M.

WELL TESTS:

Drawdown 18 ft. after hours G.P.M.

Drawdown ft. after hours G.P.M.

USE OF WATER Irrigation 88 acres Temp. °F., 19

SOURCE OF INFORMATION Registration Statement GR-17

DRILLER or DIGGER

ADDITIONAL DATA:

Log Water Level Measurements Chemical Analysis Aquifer Test

REMARKS:

Log 0-6' loam, sandy 6' thick
6'-50' sand + gravel? 44' "