

STATE ENGINEER
Salem, Oregon

YAMH Well Record
6717

STATE WELL NO. ⁵ ~~1/34-23~~ ^{N(1)}
COUNTY Yamhill
APPLICATION NO. GR-17

OWNER: Dale Fowler MAILING ADDRESS: _____

LOCATION OF WELL: Owner's No. #1 CITY AND STATE: Dayton, Oregon


5 NW 1/4 SW 1/4 Sec. 23 T. 8 S., R. 3 W., W.M.

Bearing and distance from section or subdivision corner 1332 feet south and 500 feet east from E ¹/₄ corner of section 22.

Altitude at well 100 ~~50~~ feet Interpolated

TYPE OF WELL: Drilled Date Constructed April 1936

Depth drilled 40' Depth cased 40'

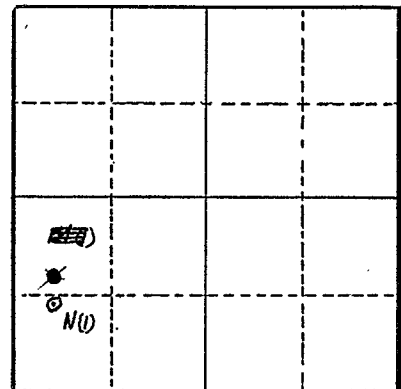

Section 23

CASING RECORD:

6-inch casing set from 0 to 40 feet.

FINISH:

None

AQUIFERS:

sand and gravels from 6 to ~~20~~ ⁴⁰ feet.

WATER LEVEL:

6 feet below land surface - 1939

PUMPING EQUIPMENT: Type Pacific Centrifugal 3" H.P. 25
Capacity 600 G.P.M.

WELL TESTS:

Drawdown 2.0 ft. after _____ hours 400 G.P.M.
Drawdown 1 ft. after _____ hours _____ G.P.M.

USE OF WATER Irrigation 88 acres Temp. _____ °F. _____, 19____

SOURCE OF INFORMATION Registration Statement GR-17

DRILLER or DIGGER _____

ADDITIONAL DATA:

Log ☒ Water Level Measurements ☒ Chemical Analysis _____ Aquifer Test _____

REMARKS: 10 feet from well #2

Log 0-6' loam, sandy 6' thick
 6'-7' sand, quick 1' "
 7'-~~10~~' gravel ~~3~~' "
 40' 28' "