

STATE ENGINEER
Salem, Oregon

Well Record

STATE WELL NO. ⁵ ~~134-23~~ ^{N(2)}
COUNTY Yamhill
APPLICATION NO. GR-17

OWNER: Dale Fowler

MAILING
ADDRESS:

LOCATION OF WELL: Owner's No. 2


CITY AND
STATE:

Dayton, Oregon

S NW $\frac{1}{4}$ SW $\frac{1}{4}$ Sec. 23 T. 8 S., R. 3 W., W.M.

Bearing and distance from section or subdivision

corner 1332 feet south and 510 feet east
from E $\frac{1}{4}$ corner of section 22.

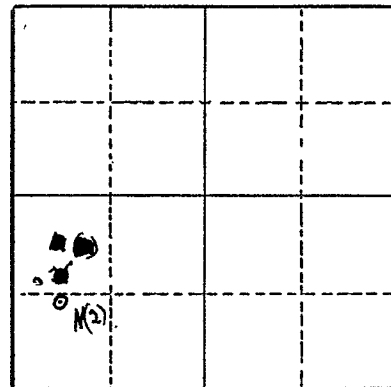

Altitude at well 50 feet Interpolation

TYPE OF WELL: Drilled Date Constructed April 1938

Depth drilled 36' Depth cased 36'

Section 23

CASING RECORD:

10-inch casing set from 0 to 36 feet.

FINISH:

None

AQUIFERS:

sand and gravels from 6' to 33 feet

WATER LEVEL:

6 feet below land surface - 1939

PUMPING EQUIPMENT: Type Pacific centrifugal 3" H.P. 25
Capacity 600 G.P.M.

WELL TESTS:

Drawdown 20 ft. after _____ hours 400 G.P.M.

Drawdown _____ ft. after _____ hours _____ G.P.M.

USE OF WATER Irrigation 88 acres Temp. _____ °F., 19____

SOURCE OF INFORMATION Registration Statement GR-17

DRILLER or DIGGER _____

ADDITIONAL DATA:

Log ☒ Water Level Measurements ☒ Chemical Analysis _____ Aquifer Test _____

REMARKS:

Log 0-6' loam, sandy 6' thick
 6'-7' sand, quick 1' "
 7'-33' gravel 16' "