

STATE ENGINEER
Salem, Oregon

YAMH
6719

Well Record

GR- 1357

STATE WELL NO. 5/3W-23N
COUNTY Yamhill
APPLICATION NO. GR-1402

OWNER: Adelbert P. Smith

MAILING

ADDRESS: Rt. 1, Box 130

LOCATION OF WELL: Owner's No.

CITY AND

STATE: Dayton, Oregon

SW $\frac{1}{4}$ SW $\frac{1}{4}$ Sec. 23 T. 5 S., R. 3 W., W.M.


Bearing and distance from section or subdivision

corner 242' N. & 689' E. from SW cor. Sec. 23

Altitude at well 100 ft.

TYPE OF WELL: Drilled Date Constructed 1944

Depth drilled 43.5 ft. Depth cased 43.5 ft.

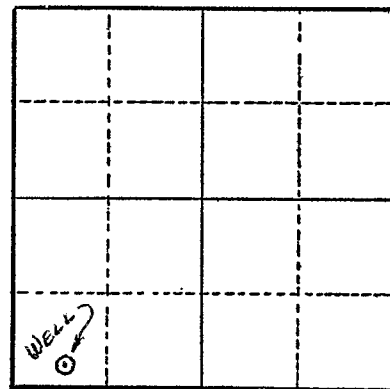

Section 23

CASING RECORD:

8 inch

FINISH:

10 perforations around casing 8 in. long every foot from 10 to 15 ft.
" " " " " " 32 to 43.5 ft.

AQUIFERS:

WATER LEVEL:

3 ft.

PUMPING EQUIPMENT: Type F.M. 2 in. Cent. H.P. 25
Capacity 260 G.P.M.

WELL TESTS:

Drawdown 7 ft. after hours 260 G.P.M.

Drawdown ft. after hours G.P.M.

USE OF WATER Irrigation Temp. °F. 19

SOURCE OF INFORMATION G. R. Record

DRILLER or DIGGER

ADDITIONAL DATA:

Log Water Level Measurements Chemical Analysis Aquifer Test

REMARKS:

Log: River silt 0 to 10 ft.
Medium gravel 10 to 15 ft.
Blue mud 15 to 32 ft.
Coarse gravel 32 to 43.5 ft.

Irrigation of 18.1 acres.