

STATE ENGINEER  
Salem, Oregon

YAMH  
6721

# Well Record


STATE WELL NO. 5/3W-230  
COUNTY Yamhill  
APPLICATION NO. GR-3156

OWNER: Curtis A. Douglas  
MAILING ADDRESS: Route 1, Box 143

LOCATION OF WELL: Owner's No. South Well  
CITY AND STATE: Dayton, Oregon

SW 1/4 SE 1/4 Sec. 23 T. 5 N. S., R. 3 W., W.M.

Bearing and distance from section or subdivision  
corner 2000' W. and 900' N.

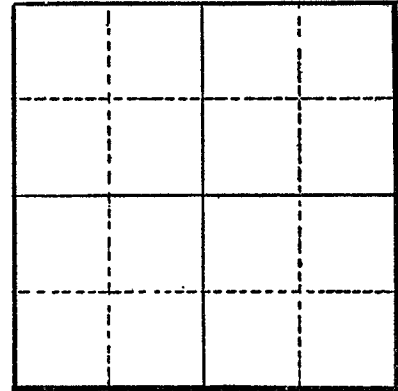

Section

Altitude at well

TYPE OF WELL: drilled Date Constructed 1936

Depth drilled 28' Depth cased 28'

### CASING RECORD:

8" from 0 to 28

### FINISH:

Perforated

### AQUIFERS:

Not available

### WATER LEVEL:

10'

PUMPING EQUIPMENT: Type 3" F.M. Centrifugal H.P. 15

Capacity 300 G.P.M.

### WELL TESTS:

Drawdown ft. after hours G.P.M.

Drawdown ft. after hours G.P.M.

USE OF WATER Irrigation Temp. °F., 19

SOURCE OF INFORMATION GR-2962

DRILLER or DIGGER Fred Wymore, Salem, Oregon

### ADDITIONAL DATA:

Log Water Level Measurements Chemical Analysis Aquifer Test

### REMARKS: