

STATE ENGINEER
Salem, Oregon

YAMH
6722

Well Record

STATE WELL NO. 5/3W-23-R
COUNTY Yamhill
APPLICATION NO. GR-1540

GR- 1483

OWNER: Harvey EWERT


MAILING ADDRESS: Rt. 1, Box 144

LOCATION OF WELL: Owner's No. #3

CITY AND STATE: Dayton, Oregon

SE 1/4 SE 1/4 Sec. 23 T. 5 S., R. 3 W., W.M.

Bearing and distance from section or subdivision corner 650' W. & 800' N. from SE cor. Sec. 23

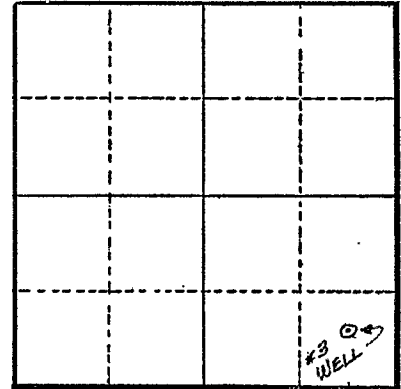

Section 23

Altitude at well 100'

TYPE OF WELL: Drilled Date Constructed 1928?

Depth drilled 25' Depth cased 25'

CASING RECORD:
10"

FINISH:

AQUIFERS:

WATER LEVEL:
10'

PUMPING EQUIPMENT: Type F. M. 3" x 3 1/2" H.P. 15
Capacity 300 G.P.M.

WELL TESTS:
Drawdown ft. after hours G.P.M.
Drawdown ft. after hours G.P.M.

USE OF WATER Irrigation Temp. °F., 19

SOURCE OF INFORMATION GR Record

DRILLER or DIGGER

ADDITIONAL DATA:

Log N.A. Water Level Measurements Chemical Analysis Aquifer Test

REMARKS:

Irrigation of 20 acres.