

STATE ENGINEER
Salem, Oregon

YAMH
6726
Well Record


STATE WELL NO. 5/3W - 24N
COUNTY YAMHILL
APPLICATION NO. GR-2037

OWNER: U. S. Alderman MAILING ADDRESS: _____

LOCATION OF WELL: Owner's No. #9 CITY AND STATE: Dayton, Oregon

SW 1/4 SW 1/4 Sec. 24 T. 5 S., R. 3 W., W.M.

Bearing and distance from section or subdivision corner 433' N. 83° 25' E.

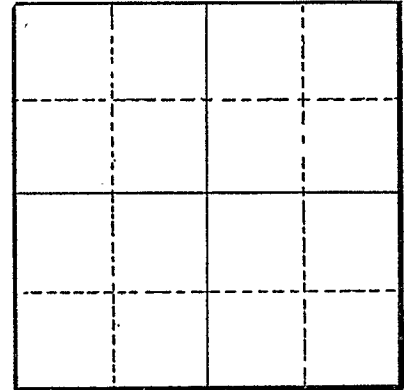

Section _____

Altitude at well _____

TYPE OF WELL: Drilled Date Constructed 1942

Depth drilled 31 Depth cased 31

CASING RECORD:

8-inch

FINISH:

Perforations from 20 to 31

AQUIFERS:

Soil, clay and gravel

WATER LEVEL:

5-feet

PUMPING EQUIPMENT: Type Fairbanks Morse 3" Centrifugal H.P. 30
Capacity 420 G.P.M.

WELL TESTS:

Drawdown _____ ft. after _____ hours _____ G.P.M.
Drawdown _____ ft. after _____ hours _____ G.P.M.

USE OF WATER Irrigation Temp. _____ °F. _____, 19_____

SOURCE OF INFORMATION GR-1963

DRILLER or DIGGER Fred Wymore, Willamette Drilling Co., Rt. 2, Salem, Oregon

ADDITIONAL DATA:

Log Water Level Measurements _____ Chemical Analysis _____ Aquifer Test _____

REMARKS:

Top soil 3 3
Yellow Clay 16 19
Water bearing gravel 12 31