

STATE ENGINEER  
Salem, Oregon

YAMH  
6734

# Well Record

STATE WELL NO. 5/3W-26A0  
COUNTY Yamhill  
APPLICATION NO. GR-407

OWNER: Clark Noble


MAILING ADDRESS: Pt. 1 Box 203

LOCATION OF WELL: Owner's No. \_\_\_\_\_

CITY AND STATE: Cayton Yamhill, Ore.

NE 1/4 NE 1/4 Sec. 26 T. 5 S., R. 3 W., W.M.

Bearing and distance from section or subdivision corner  
S. 22° 46' W. 585 ft.  
from N. E. cor. of sec. 26

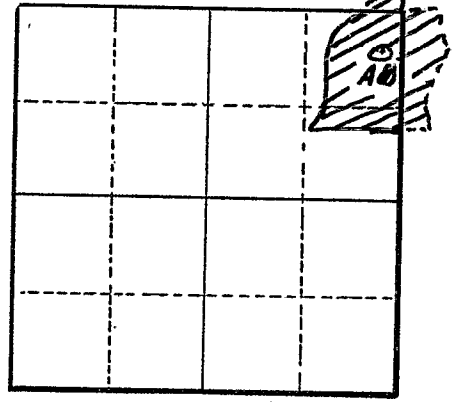

Section 26

Altitude at well 98

TYPE OF WELL: drilled Date Constructed May 23, 59

Depth drilled 32 Depth cased 32

CASING RECORD:  
10 inch

FINISH:

AQUIFERS:

WATER LEVEL:

12

PUMPING EQUIPMENT: Type Pacific Centrifugal H.P. 25  
Capacity 350 G.P.M.

WELL TESTS:

Drawdown \_\_\_\_\_ ft. after \_\_\_\_\_ hours \_\_\_\_\_ G.P.M.  
Drawdown \_\_\_\_\_ ft. after \_\_\_\_\_ hours \_\_\_\_\_ G.P.M.

USE OF WATER irrigation - 54.9 Ac. Temp. \_\_\_\_\_ °F. \_\_\_\_\_, 19\_\_\_\_

SOURCE OF INFORMATION GR 407

DRILLER or DIGGER Willamette Drilling Co., Salem, Ore.

ADDITIONAL DATA:  
Log \_\_\_\_\_ Water Level Measurements \_\_\_\_\_ Chemical Analysis \_\_\_\_\_ Aquifer Test \_\_\_\_\_

REMARKS: ✓

Sandy top soil - - - 0 to 15 ft.  
Coarse gravel, some - - - 15 to 32 ft.  
sand water