

STATE ENGINEER  
Salem, Oregon

YAMH  
6735

# Well Record


STATE WELL NO. 5/3W-26B  
COUNTY Yamhill  
APPLICATION NO. GR-3568

OWNER: Cecil LeRoy Will  
MAILING ADDRESS: Route 1, Box 141

LOCATION OF WELL: Owner's No. \_\_\_\_\_  
CITY AND STATE: Dayton, Oregon

NW 1/4 NE 1/4 Sec. 26 T. 5 S. R. 3 W., W.M.

Bearing and distance from section or subdivision  
corner 1140 ft. E. and 6 ft. S. of NE corner  
of Sec. 26

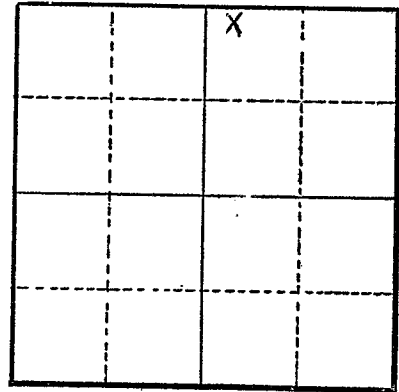

Section 26

Altitude at well \_\_\_\_\_

TYPE OF WELL: Drilled Date Constructed Oct., 1940

Depth drilled 51 ft. Depth cased 51 ft.

### CASING RECORD:

12 inch steel casing set to 36 feet  
10 inch steel casing set from 36 to 51 feet

### FINISH:

1/2 x 6 slots from 10 to 36 feet  
1/2 x 6 slots from 45 to 51 feet

### AQUIFERS:

sediments

### WATER LEVEL:

9 feet below surface

PUMPING EQUIPMENT: Type Cornell Centrifugal 3" electric H.P. 20  
Capacity 350 G.P.M.

### WELL TESTS:

Drawdown	24	ft. after	hours	350	G.P.M.
Drawdown	12	ft. after	hours	200	G.P.M.

USE OF WATER Irrigation Temp. °F. 19

SOURCE OF INFORMATION Well Registration Statement

DRILLER or DIGGER \_\_\_\_\_

### ADDITIONAL DATA:

Log  Water Level Measurements \_\_\_\_\_ Chemical Analysis \_\_\_\_\_ Aquifer Test \_\_\_\_\_

### REMARKS:

Log:	Thickness	Depth to Bottom
Silt loam	10	10
Sand & pean gravel	26	36
Blue clay	8	44
Sand & gravel	7	51