

STATE ENGINEER  
Salem, Oregon

# Well Record

STATE WELL NO. 5/3W - 26F  
COUNTY YAMHILL  
APPLICATION NO. GR-2038

*YAMHILL*  
*6736*

OWNER: U. S. Alderman

MAILING ADDRESS:

LOCATION OF WELL: Owner's No. #10


CITY AND STATE:

Dayton, Oregon

SE  $\frac{1}{4}$  NW  $\frac{1}{4}$  Sec. 26 T. 5 N. S., R. 3 E. W., W.M.

Bearing and distance from section or subdivision

corner 3465' N. 29° 46' E.

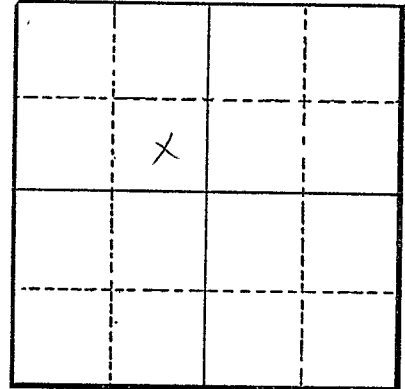

Section .....

Altitude at well .....

TYPE OF WELL: Drilled Date Constructed 1952

Depth drilled 45 Depth cased 45

### CASING RECORD:

10-inch

### FINISH:

Perforations from 23 to 45

### AQUIFERS:

Sand and gravel

### WATER LEVEL:

5-feet

PUMPING EQUIPMENT: Type Fairbanks Morse 3" Centrifugal H.P. 30  
Capacity 420 G.P.M.

### WELL TESTS:

Drawdown ..... ft. after ..... hours ..... G.P.M.

Drawdown ..... ft. after ..... hours ..... G.P.M.

USE OF WATER Irrigation Temp. ..... °F., 19.....

SOURCE OF INFORMATION GR-1964

DRILLER or DIGGER Fred Wymore, Willamette Drilling Co., Rt. 2, Salem, Oregon

### ADDITIONAL DATA:

Log  Water Level Measurements ..... Chemical Analysis ..... Aquifer Test .....

### REMARKS:

Top soil	3	3
Yellow clay	15	18
Water Bearing sand	4	22
Water Bearing sand and loose gravel	11	33
Tight gravel with water	12	45