

STATE ENGINEER  
Salem, Oregon

# Well Record

STATE WELL NO. 5/3W - 26K  
COUNTY YAMHILL  
APPLICATION NO. GR-2040

**YAMH**  
**0737**

OWNER: U. S. Alderman


MAILING ADDRESS: \_\_\_\_\_

LOCATION OF WELL: Owner's No. #12

CITY AND STATE: Dayton, Oregon

NW  $\frac{1}{4}$  SE  $\frac{1}{4}$  Sec. 26 T. 5 N. S., R. 3 E. W., W.M.

Bearing and distance from section or subdivision corner 3749' N. 62° 11' E.

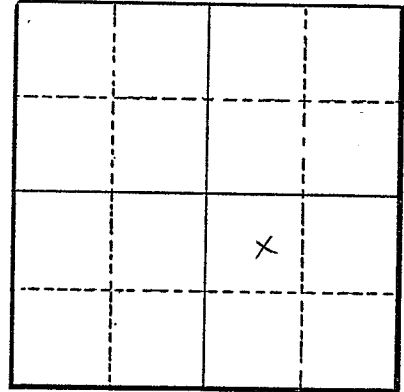

Section \_\_\_\_\_

Altitude at well \_\_\_\_\_

TYPE OF WELL: Drilled Date Constructed 1943

Depth drilled 29 Depth cased 29

### CASING RECORD:

15-inch

### FINISH:

Perforations from 17 to 29

### AQUIFERS:

Clay, soil, and gravel

### WATER LEVEL:

5-feet

PUMPING EQUIPMENT: Type Fairbanks Morse 4" Centrifugal H.P. 50  
Capacity 550 G.P.M.

### WELL TESTS:

Drawdown \_\_\_\_\_ ft. after \_\_\_\_\_ hours \_\_\_\_\_ G.P.M.

Drawdown \_\_\_\_\_ ft. after \_\_\_\_\_ hours \_\_\_\_\_ G.P.M.

USE OF WATER Irrigation Temp. \_\_\_\_\_ °F. \_\_\_\_\_, 19\_\_\_\_

SOURCE OF INFORMATION GR-1966

DRILLER or DIGGER Fred Wymore, Willamette Drilling Co., Rt. 2, Salem, Oregon

### ADDITIONAL DATA:

Log  Water Level Measurements \_\_\_\_\_ Chemical Analysis \_\_\_\_\_ Aquifer Test \_\_\_\_\_

### REMARKS:

Top soil	3	3
Yellow clay	10	13
Water bearing gravel	16	29