

STATE ENGINEER
Salem, Oregon

YAMH
6738 **Well Record**

STATE WELL NO. 5/3W - 26L
COUNTY YAMHILL
APPLICATION NO. GR-2039

OWNER: U. S. Alderman


MAILING ADDRESS:

LOCATION OF WELL: Owner's No. #11

CITY AND STATE: Dayton, Oregon

NE 1/4 SW 1/4 Sec. 26 T. 5 N. S., R. 3 E. W., W.M.

Bearing and distance from section or subdivision corner 2376' N. 34° 48' E.

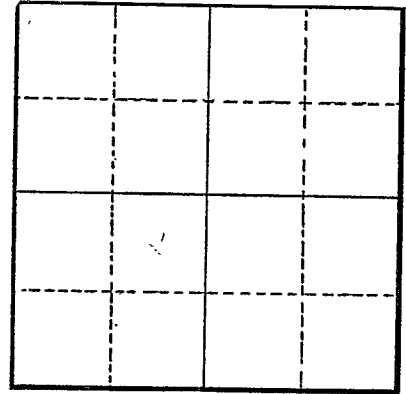

Section

Altitude at well

TYPE OF WELL: Drilled Date Constructed 1945

Depth drilled 34 Depth cased 34

CASING RECORD:

10-inch

FINISH:

Perforations from 25 to 34

AQUIFERS:

Sand, gravel, clay and soil

WATER LEVEL:

5-feet

PUMPING EQUIPMENT: Type Fairbanks Morse 4" Centrifugal H.P. 40
Capacity 420 G.P.M.

WELL TESTS:

Drawdown ft. after hours G.P.M.

Drawdown ft. after hours G.P.M.

USE OF WATER Irrigation Temp. °F., 19.....

SOURCE OF INFORMATION GR-1965

DRILLER or DIGGER Fred Wymore, Willamette Drilling Co., Rt. 2, Salem, Oregon

ADDITIONAL DATA:

Log Water Level Measurements Chemical Analysis Aquifer Test

REMARKS:

Top soil 3 3
Yellow clay 20 23
Water bearing sand 5 28
Water bearing gravel 6 34