

STATE ENGINEER
Salem, Oregon

YAMH
6740

Well Record

STATE WELL NO. 5/20-27 P(1)
COUNTY Yamhill
APPLICATION NO. GR-119

OWNER: Louie W. Magee


MAILING ADDRESS: Rt 1, Box 145

LOCATION OF WELL: Owner's No. 1

CITY AND STATE: Dayton, Oregon

SE 1/4 SW 1/4 Sec. 27 T. 5 S., R. 3 W., W.M.

Bearing and distance from section or subdivision corner 1910 feet N61°30'E of SW corner of section 27.

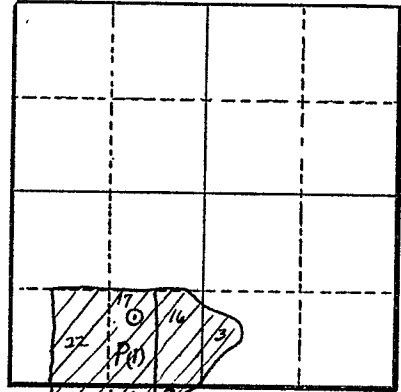

Altitude at well 100 feet Interpolated

TYPE OF WELL: Drilled Date Constructed 8/12/54

Depth drilled 45 Depth cased 45

Section 27

CASING RECORD:

10 — inch casing set from 0 to 45 feet.

FINISH:

Mills knife slots from 35 to 45 feet.

AQUIFERS:

no record.

WATER LEVEL:

6 feet below land surface 8/1954

PUMPING EQUIPMENT: Type centrifugal

Elect. H.P. 15

Capacity 250 G.P.M.

WELL TESTS:

Drawdown 20 ft. after _____ hours 300 G.P.M.

Drawdown _____ ft. after _____ hours _____ G.P.M.

USE OF WATER Irrigation 72 acres Temp. _____ °F., 19____

SOURCE OF INFORMATION Registration Statement GR-119

DRILLER or DIGGER Fred Wymore

ADDITIONAL DATA:

Log No Water Level Measurements _____ Chemical Analysis _____ Aquifer Test _____

REMARKS: