

STATE ENGINEER
Salem, Oregon

YAMH
6750

Well Record


STATE WELL NO. 5/3W-28
COUNTY YAMHILL
APPLICATION NO. GR-2723

OWNER: E. W. Budke and M. Annette Budke MAILING ADDRESS: Box 128

LOCATION OF WELL: Owner's No. CITY AND STATE: Dayton, Oregon

NW 1/4 NE 1/4 SE 1/4 Sec. 28 T. 5 S, R. 3 W., W.M.

Bearing and distance from section or subdivision corner 2350' N. of SE corner Sec. 28 and 810' W. a portion of Daniel Matheny Donation Land Claim #38

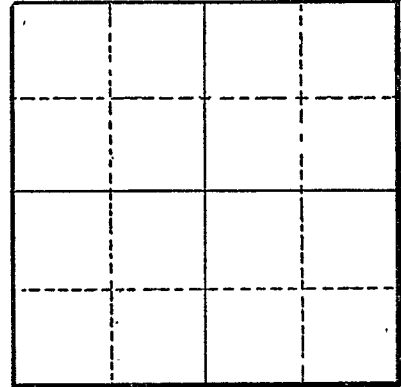

Section

Altitude at well

TYPE OF WELL: drilled Date Constructed 1942

Depth drilled 29 Depth cased 27

CASING RECORD:

8-inch

FINISH:

1/4" wide and 4" long perforations from 18 to 27

AQUIFERS:

Silt, sand and gravel

WATER LEVEL:

4-feet

PUMPING EQUIPMENT: Type Pacific H.P. 20
Capacity 300 G.P.M.

WELL TESTS:

Drawdown 8 ft. after hours Pumping 280 G.P.M.
Drawdown ft. after hours G.P.M.

USE OF WATER irrigation Temp. °F. 19

SOURCE OF INFORMATION GR-2576

DRILLER or DIGGER

ADDITIONAL DATA:
Log X Water Level Measurements Chemical Analysis Aquifer Test

REMARKS:

River silt 19
Sand and gravel 10