

STATE ENGINEER  
Salem, Oregon

YAMH  
6790

# Well Record

STATE WELL NO. 5/3W-30 M(1)  
COUNTY Yam Hill  
APPLICATION NO. GR-138

OWNER: Gust Janzen


MAILING ADDRESS: Rt 1

LOCATION OF WELL: Owner's No. 1

CITY AND STATE: Dayton, Oregon

NW 1/4 SW 1/4 Sec. 30 T. 5 S., R. 3 W., W.M.

Bearing and distance from section or subdivision corner 300 feet SW of iron pipe in corner of Lots 44 & 48 or

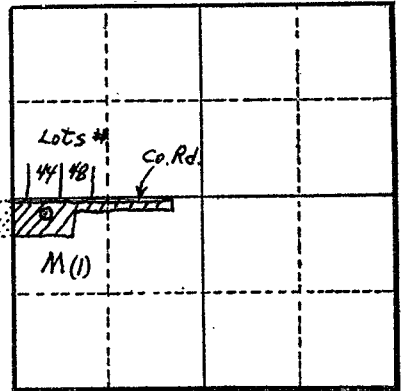

Section 30

Altitude at well 180 feet Interpolated

TYPE OF WELL: Drilled Date Constructed Nov. 1952

Depth drilled 91 Depth cased 91

### CASING RECORD:

8 inch casing set from 0 to 91 feet.

### FINISH:

Torch slots set from 51 to 91 feet.

### AQUIFERS:

Rock from 70 to 91 feet.

### WATER LEVEL:

60 feet below land surface. 11/10/52

PUMPING EQUIPMENT: Type Fairbanks-Morse centrifugal 2" x 1 1/2" H.P. 7 1/2  
Capacity 135 G.P.M.

### WELL TESTS:

Drawdown	<u>25</u>	ft. after	_____	hours	<u>125</u>	_____	G.P.M.
Drawdown	<u>78</u>	ft. after	_____	hours	<u>175</u>	_____	G.P.M.

USE OF WATER Irrigation 33 acres Temp. \_\_\_\_\_ °F., 19 \_\_\_\_\_

SOURCE OF INFORMATION Registration Statement GR-138

DRILLER or DIGGER J.T. Miller Box 198 Beverly, Oregon

### ADDITIONAL DATA:

Log  Water Level Measurements \_\_\_\_\_ Chemical Analysis \_\_\_\_\_ Aquifer Test \_\_\_\_\_

### REMARKS:

\* Flowing well during winter months - Begins Dec of each year & end in April.  
19pm approx. Q  
Supplemental to Permit # 20188 Mar. 1950 - 30 acres.

