

YAMH Well Record
6872

STATE WELL NO. 5/LW - 7A
COUNTY YAMHILL
APPLICATION NO. GR-2000

OWNER: Charlie W. Reed


MAILING ADDRESS: Rt. 1, Box 202

LOCATION OF WELL: Owner's No. _____

CITY AND STATE: McMinnville, Oregon

NE 1/4 NE 1/4 Sec. 7 T. 5 N. S., R. 4 E. W., W.M.

Bearing and distance from section or subdivision corner S. 57° W. 1400'

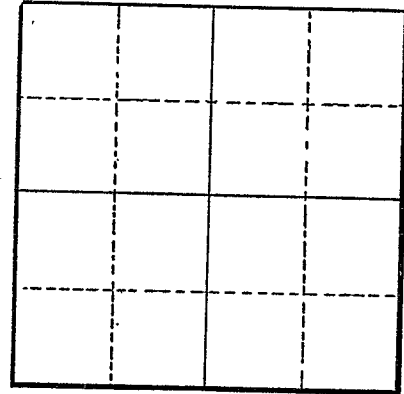

Section _____

Altitude at well _____

TYPE OF WELL: Auger Date Constructed 1954

Depth drilled 29 Depth cased 29

CASING RECORD:

16-Inch

FINISH:

AQUIFERS:

Soil, sand, clay & gravel

WATER LEVEL:

3-feet

PUMPING EQUIPMENT: Type Starite Centrifugal

Capacity 180 G.P.M. H.P. 15

WELL TESTS:

Drawdown _____ ft. after _____ hours _____ G.P.M.

Drawdown _____ ft. after _____ hours _____ G.P.M.

USE OF WATER Irrigation

Temp. _____ °F. _____, 19_____

SOURCE OF INFORMATION GR-1930

DRILLER or DIGGER _____

ADDITIONAL DATA:

Log X Water Level Measurements _____ Chemical Analysis _____ Aquifer Test _____

REMARKS:

Top Soil 5
Blue Clay 16 to 21
Sand & Gravel 8 to 29