

STATE ENGINEER
Salem, Oregon

OBSERVATION WELL
Well Record

STATE WELL NO. 574W-112(1)
COUNTY Uamhill
APPLICATION NO. GR-113

YAMH
6929


OWNER: Norman J. Langhurst

MAILING ADDRESS: _____

LOCATION OF WELL: Owner's No. 1

CITY AND STATE: McMinnville, Oregon

NW 1/4 NW 1/4 Sec. 11 T. 5 S., R. 4 W., W.M.

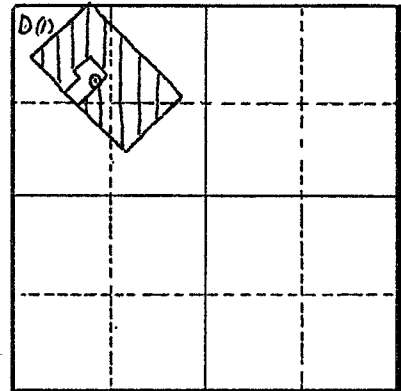

Bearing and distance from section or subdivision corner 1540 feet S 47° 40' E of NW corner of section 11.

Section 11

Altitude at well 160 feet Interpolated

TYPE OF WELL: Drilled Date Constructed 11/10/48

Depth drilled 96 Depth cased 96

CASING RECORD:

6 — inch casing set from 0 to 96 feet.

FINISH:

6 rows 1/8" wide from 75 feet to 96 feet.

AQUIFERS:

sand, block from 72 to 96 feet.

WATER LEVEL:

15 feet below land surface. Nov. 1949

PUMPING EQUIPMENT: Type Fairbanks-Morse 13 stage Turbine G.F. H.P. 5
Capacity _____ G.P.M.

WELL TESTS:

Drawdown 6.4 ft. after _____ hours 90 G.P.M.
Drawdown _____ ft. after _____ hours _____ G.P.M.

USE OF WATER Irrigation 34 acres Temp. _____ °F., 19 _____

SOURCE OF INFORMATION Registration Statement GR-113

DRILLER or DIGGER _____

ADDITIONAL DATA:

Log Water Level Measurements _____ Chemical Analysis _____ Aquifer Test _____

REMARKS:

