

STATE ENGINEER
Salem, Oregon

YAMH

Well Record

STATE WELL NO. ¹⁹ 54W-18 D(1)
COUNTY Yamhill
APPLICATION NO. GR-46


7038

OWNER: *WR and May F. Konzelman* MAILING ADDRESS: *RFD #1*

LOCATION OF WELL: Owner's No. *1* CITY AND STATE: *Mc Minnville, Oregon*

NW 1/4 NW 1/4 Sec. ¹⁹ *18* T. ⁵ *5* S., R. ⁴ *4* W., W.M.

Bearing and distance from section or subdivision corner *527 feet east and 219 feet north*
e. from N.E. corner of John T. Jeffries
D.L.C.

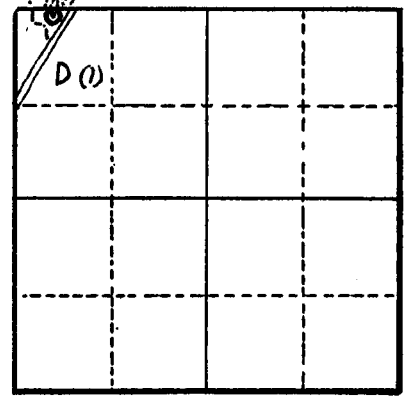

Altitude at well ^{145'} ~~55~~ feet *Interpolated*

TYPE OF WELL: *Drilled* Date Constructed *April 1946*

Depth drilled *51'* Depth cased *51'*

Section *18*

CASING RECORD:

6-inch casing set from 0 to 51 feet.

FINISH:

slit perforations 1/4" x 1"; 25 perf/foot from 35' to 51 feet.

AQUIFERS:

Gravel from 45' to 51 feet.

WATER LEVEL:

35 feet below land surface. April 1946

PUMPING EQUIPMENT: Type *Jacuzzi Jet* H.P. *5*
Capacity *70* G.P.M.

WELL TESTS:

Drawdown *unkn* ft. after *—* hours *—* G.P.M.
Drawdown *—* ft. after *—* hours *—* G.P.M.

USE OF WATER *Irrigation 12 acres* Temp. *—* °F., 19 *—*

SOURCE OF INFORMATION *Registration Statement GR-46*

DRILLER or DIGGER *—*

ADDITIONAL DATA:

Log Water Level Measurements Chemical Analysis Aquifer Test

REMARKS:

