

STATE ENGINEER
Salem, Oregon

YAMH

Well Record


STATE WELL NO. 5/4W-19K
COUNTY YAMHILL
APPLICATION NO. GR-832

OWNER: Donald E. Warner 7041 MAILING ADDRESS: RFD #1

LOCATION OF WELL: Owner's No. CITY AND STATE: McMinnville, Oregon

NW 1/4 SE 1/4 Sec. 19 T. 5 S., R. 4 W., W.M.

Bearing and distance from section or subdivision corner About 600' E and 700' S from center of Section 19 or 400' W & 900' S NE corner

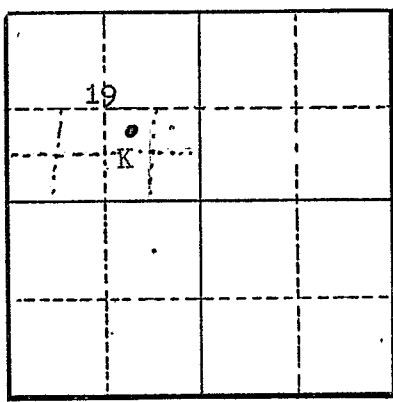

Section 19

Altitude at well 300'

TYPE OF WELL: Drilled Date Constructed 1952

Depth drilled 89' Depth cased 89'

CASING RECORD:
8-inch

FINISH:
Perforated from 60' to 70'

AQUIFERS:

WATER LEVEL:
40'

PUMPING EQUIPMENT: Type Bukeley Oil Tube H.P. 15
Capacity 200 G.P.M.

WELL TESTS:
Drawdown 75 ft. after 160 hours G.P.M.
Drawdown ft. after hours G.P.M.

USE OF WATER Irrigation Temp. °F., 19

SOURCE OF INFORMATION GR-3827
DRILLER or DIGGER Not Available

ADDITIONAL DATA:
Log Water Level Measurements Chemical Analysis Aquifer Test

REMARKS:

