

STATE ENGINEER
Salem, Oregon

YAMH

7047 Well Record

STATE WELL NO. 5/AW-20 P(1)
COUNTY Yamhill
APPLICATION NO. GR-431

OWNER: Municipal City of Amity

MAILING ADDRESS:


LOCATION OF WELL: Owner's No. #1

CITY AND STATE:

Amity, Ore

SE 1/4 SW 1/4 Sec. 20 T. 5 S., R. 4 W., W.M.

Bearing and distance from section or subdivision corner 1820 FT. E & 470 FT. N. of S.W. cor. of sec. 20

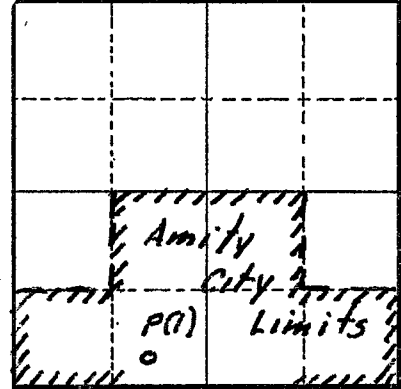

Altitude at well 158

TYPE OF WELL: drilled Date Constructed July 1951

Depth drilled 94 Depth cased 94

Section 20

CASING RECORD:

8 inch

FINISH:

AQUIFERS:

WATER LEVEL:

30

PUMPING EQUIPMENT: Type Fairbanks Morse

H.P. 7

Capacity 150 G.P.M.

WELL TESTS:

Drawdown 60 ft. after 60 hours G.P.M.

Drawdown ft. after hours G.P.M.

USE OF WATER Municipal use

Temp. °F., 19.

SOURCE OF INFORMATION GR-431

DRILLER or DIGGER Wilcox

ADDITIONAL DATA:

Log X Water Level Measurements Chemical Analysis Aquifer Test

REMARKS:

