

STATE ENGINEER
Salem, Oregon

YAMH OBSERVATION WELL
7058 Well Record

STATE WELL NO. 544-2010
COUNTY Yamhill
APPLICATION NO. GR-431

OWNER: City of Amity


MAILING ADDRESS: _____

LOCATION OF WELL: Owner's No. #2

CITY AND STATE: Amity, Ore

SW 1/4 SW 1/4 Sec. 20 T. 5 S., R. 4 W., W.M.

Bearing and distance from section or subdivision corner 380 Ft. E. & 340 Ft. N. of S.W. cor. of sec. 20.

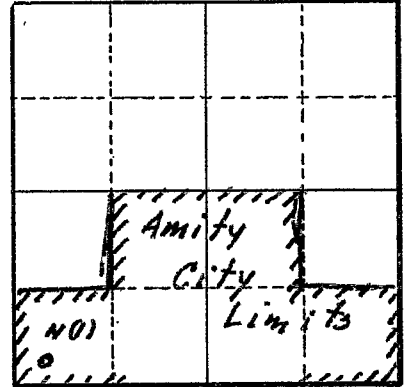

Section 201

Altitude at well 158

TYPE OF WELL: drilled Date Constructed July 1953

Depth drilled 126 Depth cased _____

CASING RECORD:

10 inch

FINISH: _____

AQUIFERS: _____

WATER LEVEL:

30

PUMPING EQUIPMENT: Type Jacuzzi Turbine H.P. 7 1/2
Capacity set 60 G.P.M.

WELL TESTS:

Drawdown 97 ft. after _____ hours 60 G.P.M.
Drawdown _____ ft. after _____ hours _____ G.P.M.

USE OF WATER Municipal use Temp. _____ °F., 19 _____

SOURCE OF INFORMATION GR-431

DRILLER or DIGGER Wilcox Drilling Co.; McMinnville, Ore

ADDITIONAL DATA:

Log Water Level Measurements _____ Chemical Analysis _____ Aquifer Test _____

REMARKS: _____

