

STATE ENGINEER
Salem, Oregon

YAMH
7/41

OBSERVATION WELL
Well Record

STATE WELL NO. 5/4W-27E
COUNTY Amity Yamhill
APPLICATION NO. GR-375

OWNER: AIF DeRaeve

MAILING ADDRESS: Amity

LOCATION OF WELL: Owner's No. _____

CITY AND STATE: Amity, Ore


Sw 1/4 NW 1/4 Sec. 27 T. 5 S., R. 4 W., W.M.

Bearing and distance from section or subdivision

corner South 2075' & 1750' East of

NW Cor. of W. Buffam DLC (No. T. 1295 CL 48)

In T5S R4W W.M.

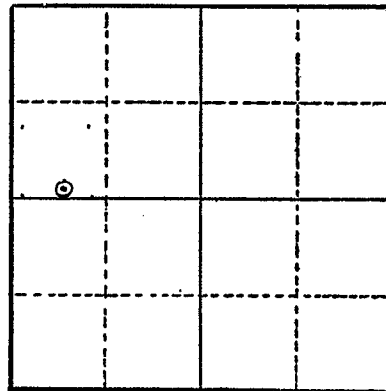

Section 27

Altitude at well ✓

TYPE OF WELL: drilled Date Constructed Mar, 1953

Depth drilled 77 Depth cased 50

CASING RECORD:

0' - 50'

10" Steel

FINISH:

AQUIFERS:

WATER LEVEL:

18'

PUMPING EQUIPMENT: Type Fairbanks Morse H.P. 10

Capacity 200 G.P.M.

WELL TESTS:

Drawdown 55 ft. after _____ hours 120 G.P.M.

Drawdown _____ ft. after _____ hours _____ G.P.M.

USE OF WATER Irrigation Temp. _____ °F. _____, 19____

SOURCE OF INFORMATION _____

DRILLER or DIGGER _____

ADDITIONAL DATA:

Log ✓ Water Level Measurements _____ Chemical Analysis _____ Aquifer Test _____

REMARKS:

